
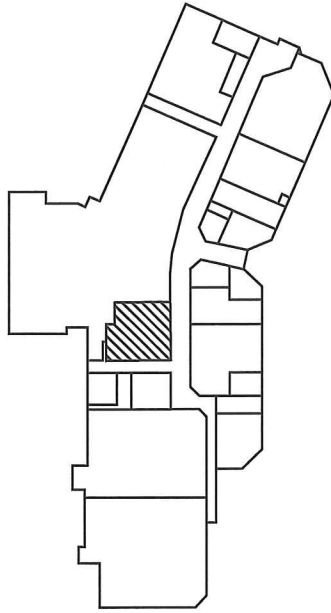


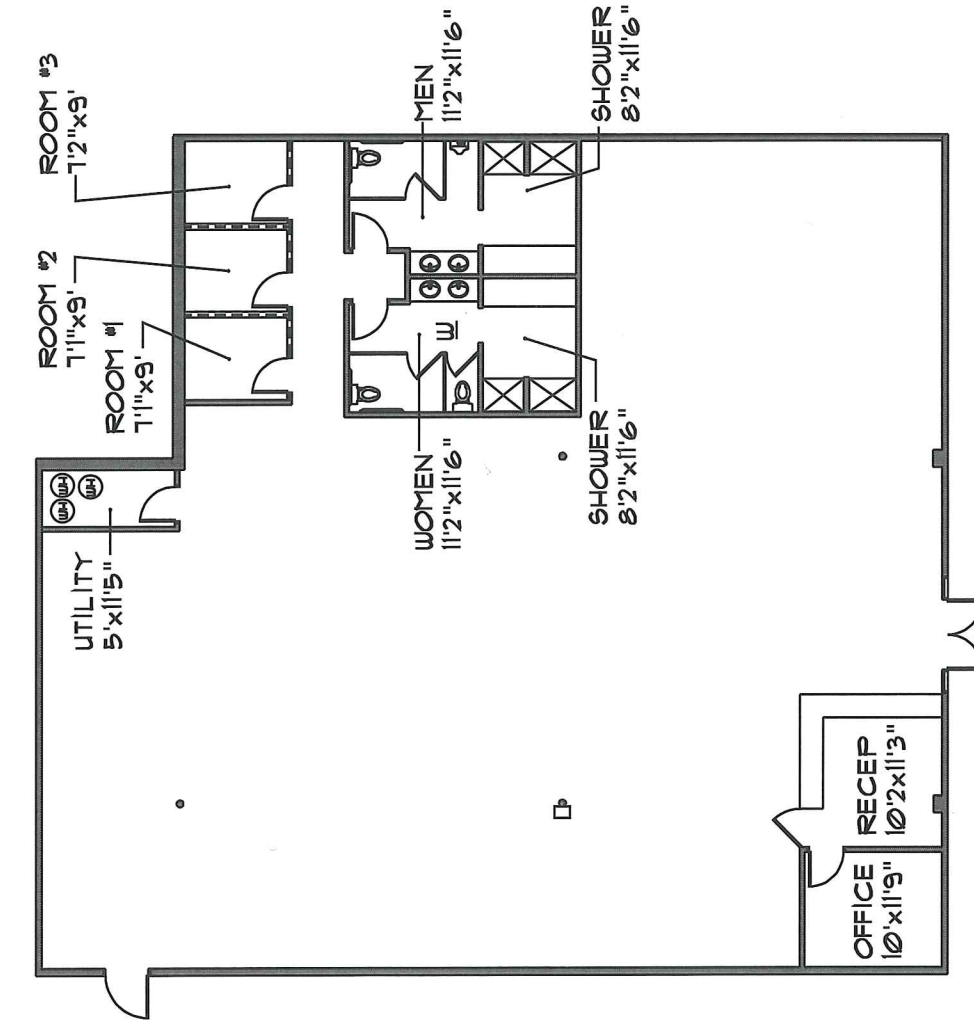

2 LOCATION KEY
 A1 SCALE: N.T.S.

CONSTRUCTION KEY	
	EXISTING CONSTRUCTION
	EXISTING PARTIAL HGT. CONSTRUCTION

1
A1

SUITE 1112 AS-BUILT LAYOUT - 5,377 SF
SHAKOPEE TOWN SQUARE
Scale N.T.S.

Job Code SHAKTSGEN Date 02.05.09
Drawn By ML Reviewed By KH
Filename SHAKTSGEN\SUITE112FV

BDH&YOUNG
 SPACE DESIGN

4510 West 77th Street, Suite 101, Edina, Minnesota 55435
 952-893-9020 Fax 952-893-9299
 www.bdhyoung.com