


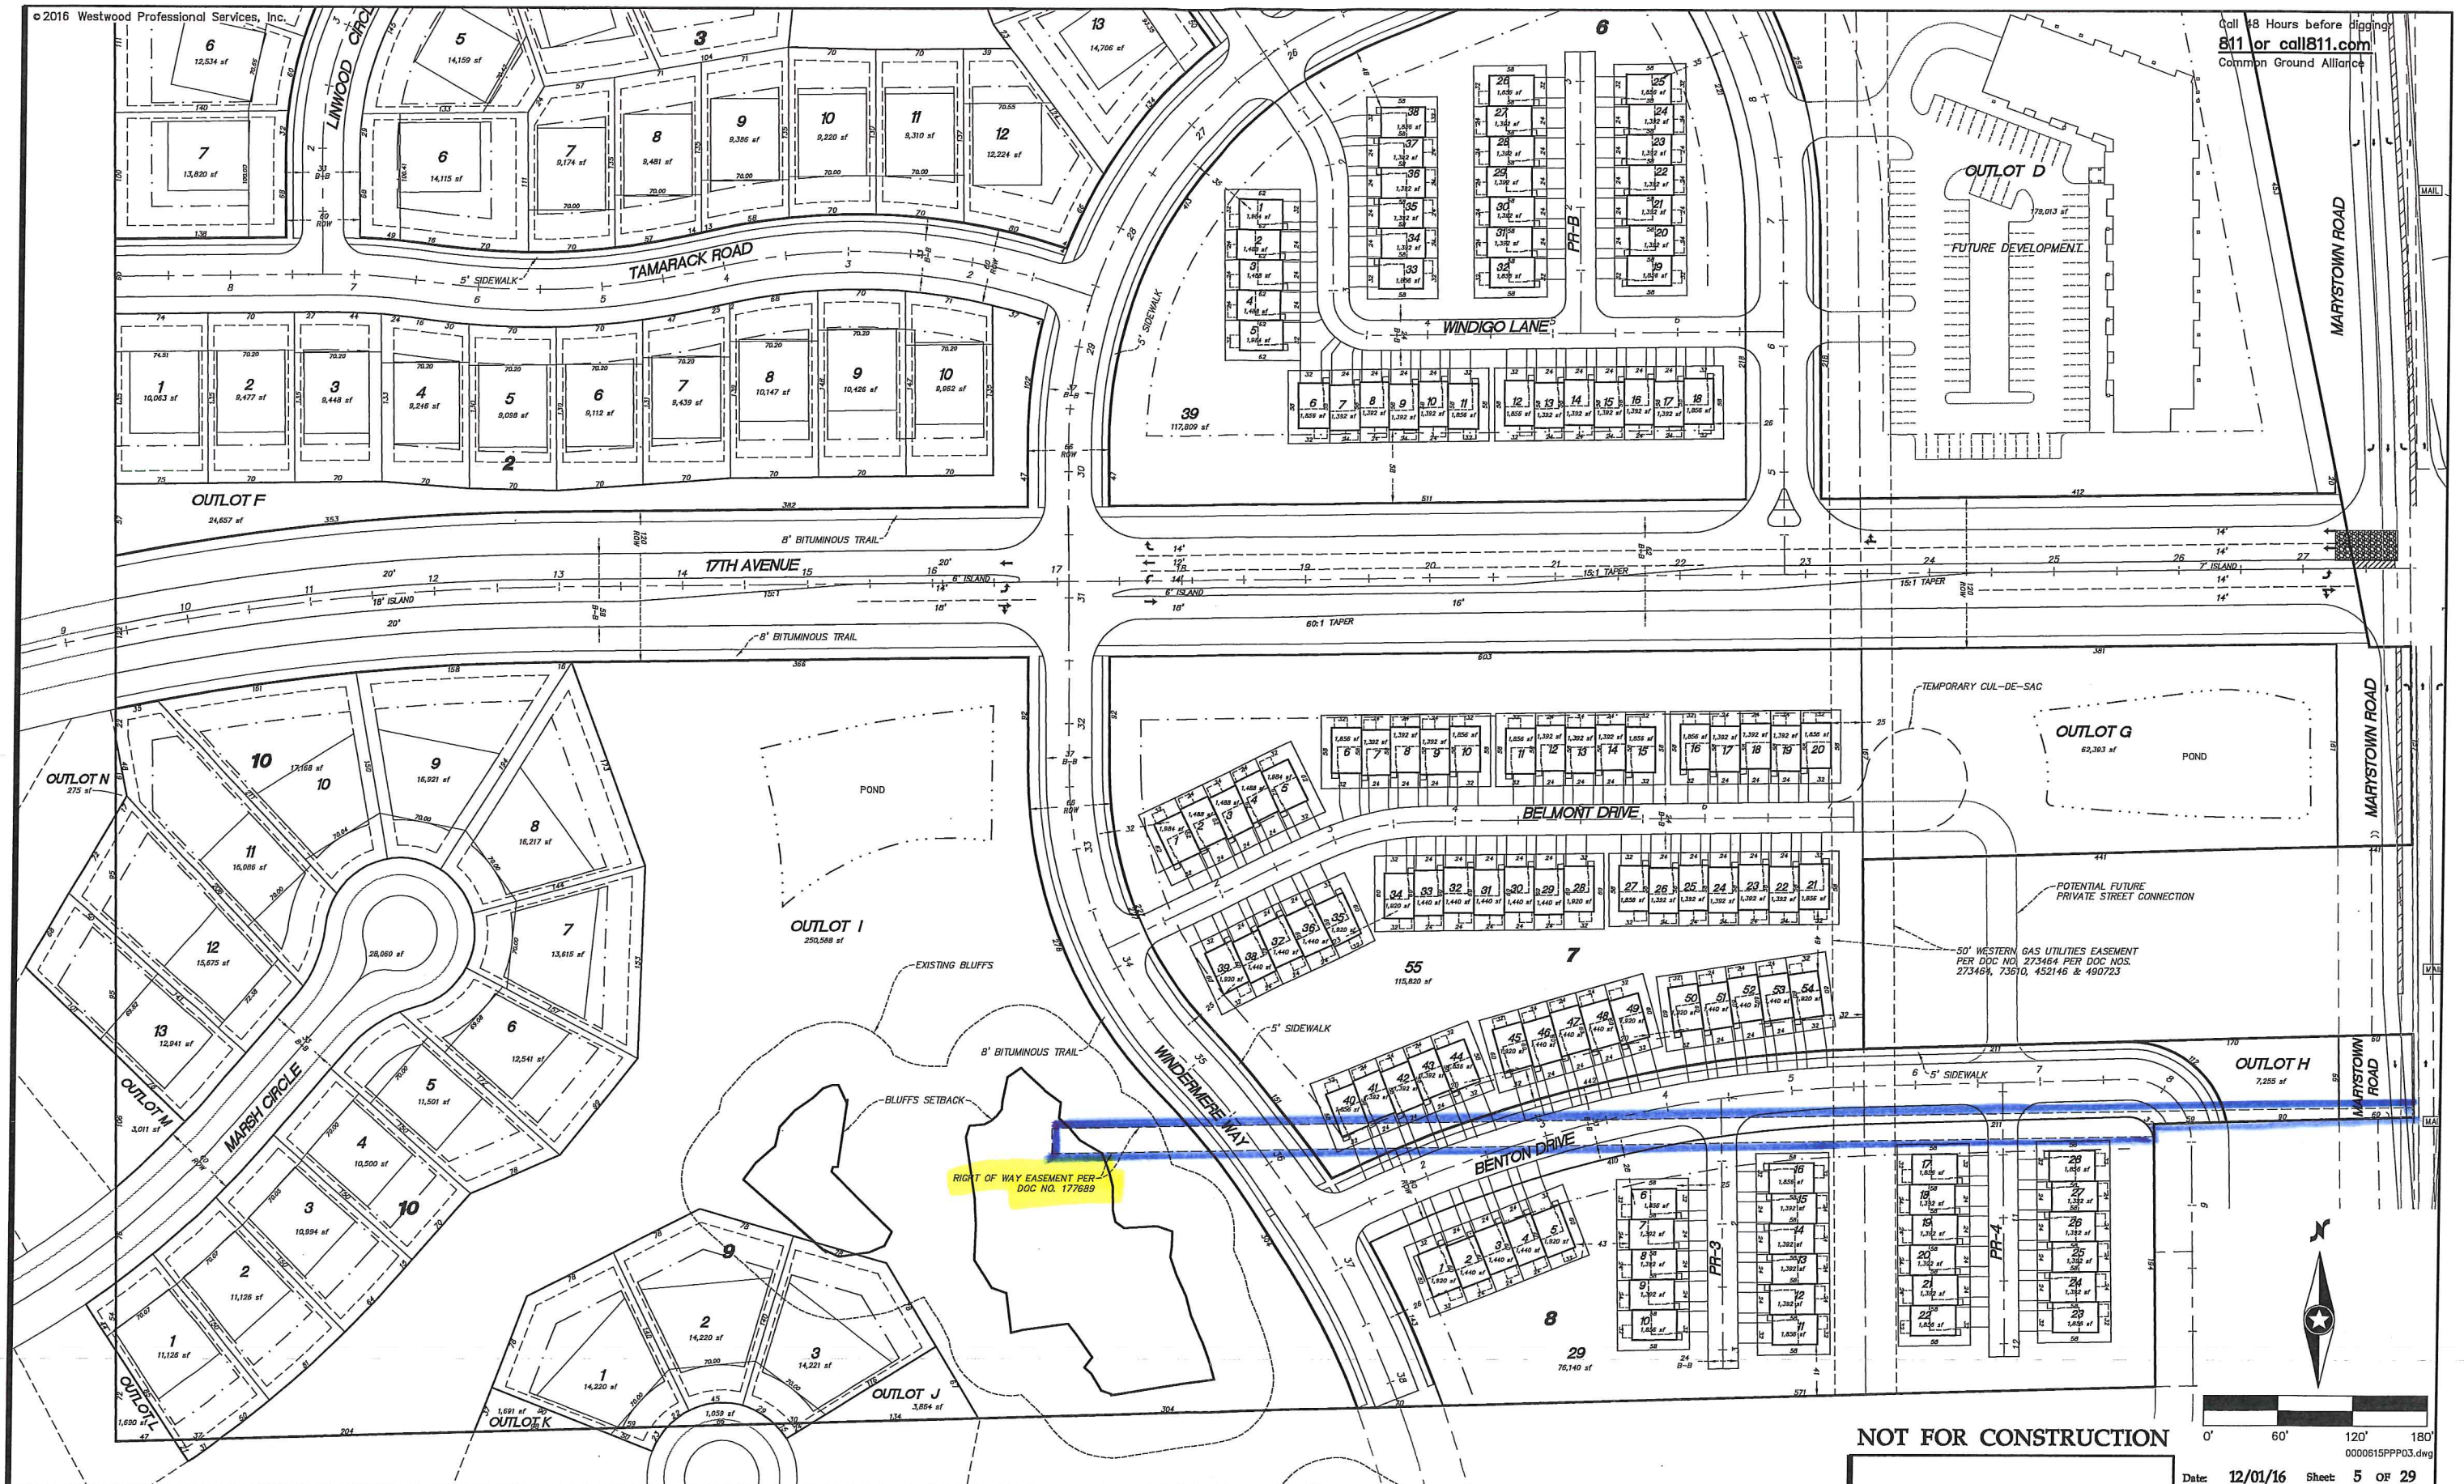

Westwood

Phone (652) 937-5150 7699 Anagram Drive
Fax (652) 937-5822 Eden Prairie, MN 55344
Toll Free (888) 637-5150 westwoodps.com
Westwood Professional Services, Inc.

I hereby certify that this plan was prepared by me or under my direct supervision and that I am a duly Licensed LAND SURVEYOR under the laws of the State of Minnesota.

Craig W. Morse
Date 12/01/16 License No. 23021

Revisions

Designed: FDH II
Checked: FDH II
Drawn: DWR
Record Drawing by/date:

Prepared for:

D.R. Horton, Inc - Minnesota
20860 Kenbridge Court, Suite 100
Lakeville, MN, 55044

Windermere

Shakopee, Minnesota

Preliminary Plat
- South

Date 12/01/16 Sheet 5 OF 29

0000615PP03.dwg